

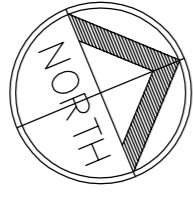


- SERVICE KEY**
- Telecom
  - Water
  - Electric
  - Data
  - Gas
  - Foul drainage
  - Cable ducts for gates

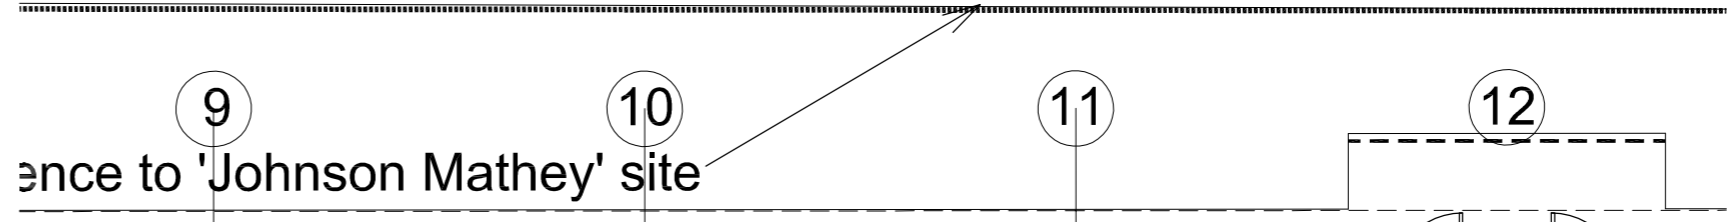

1ST. FLOOR - UNIT 3

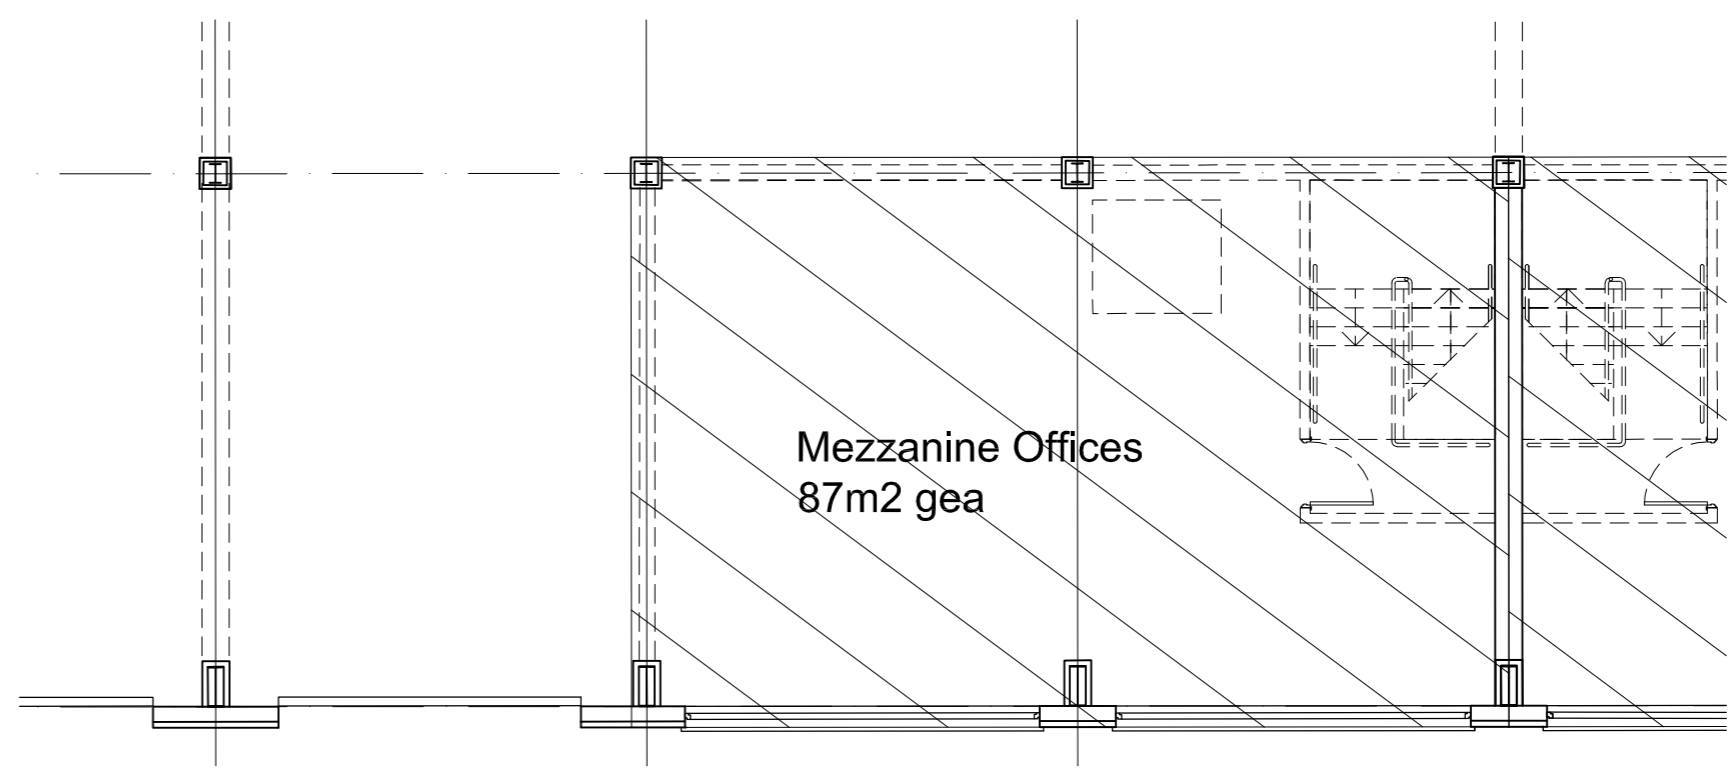

**UNIT 3**

**UNIT 3**

515m2 gross  
external footprint  
494m2 gia

51  
ex  
49


SSL 16.000

SSL


Rooflights over total area to  
achieve 10% of floor area

Roof  
achi

GROUND FLOOR - UNIT 3

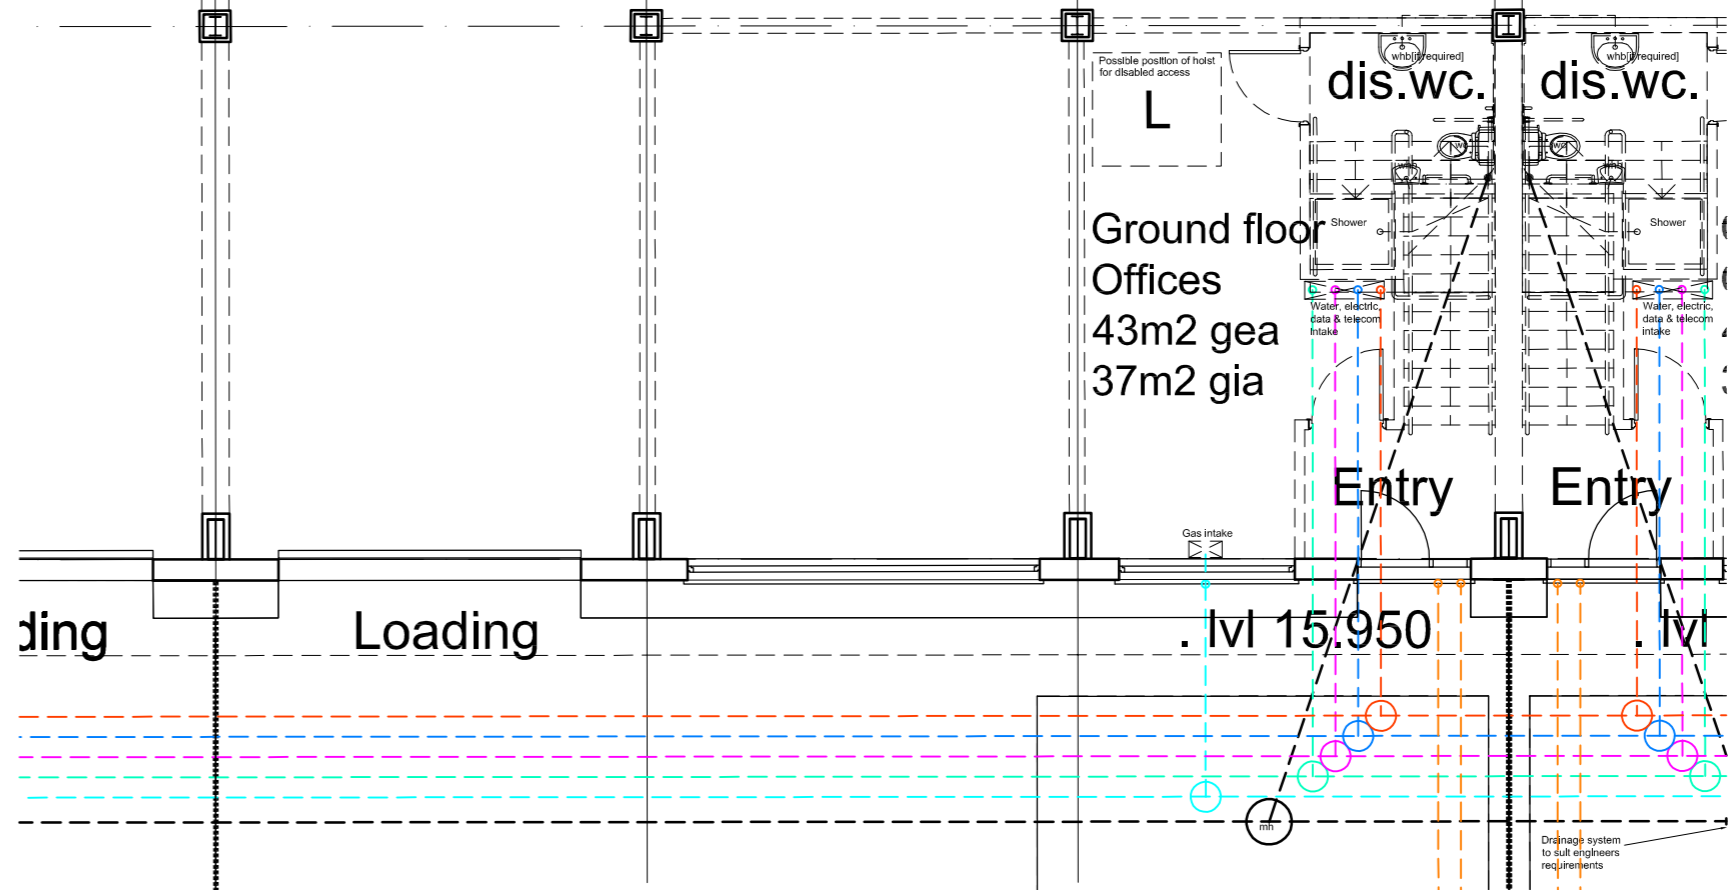

7 car parking spaces

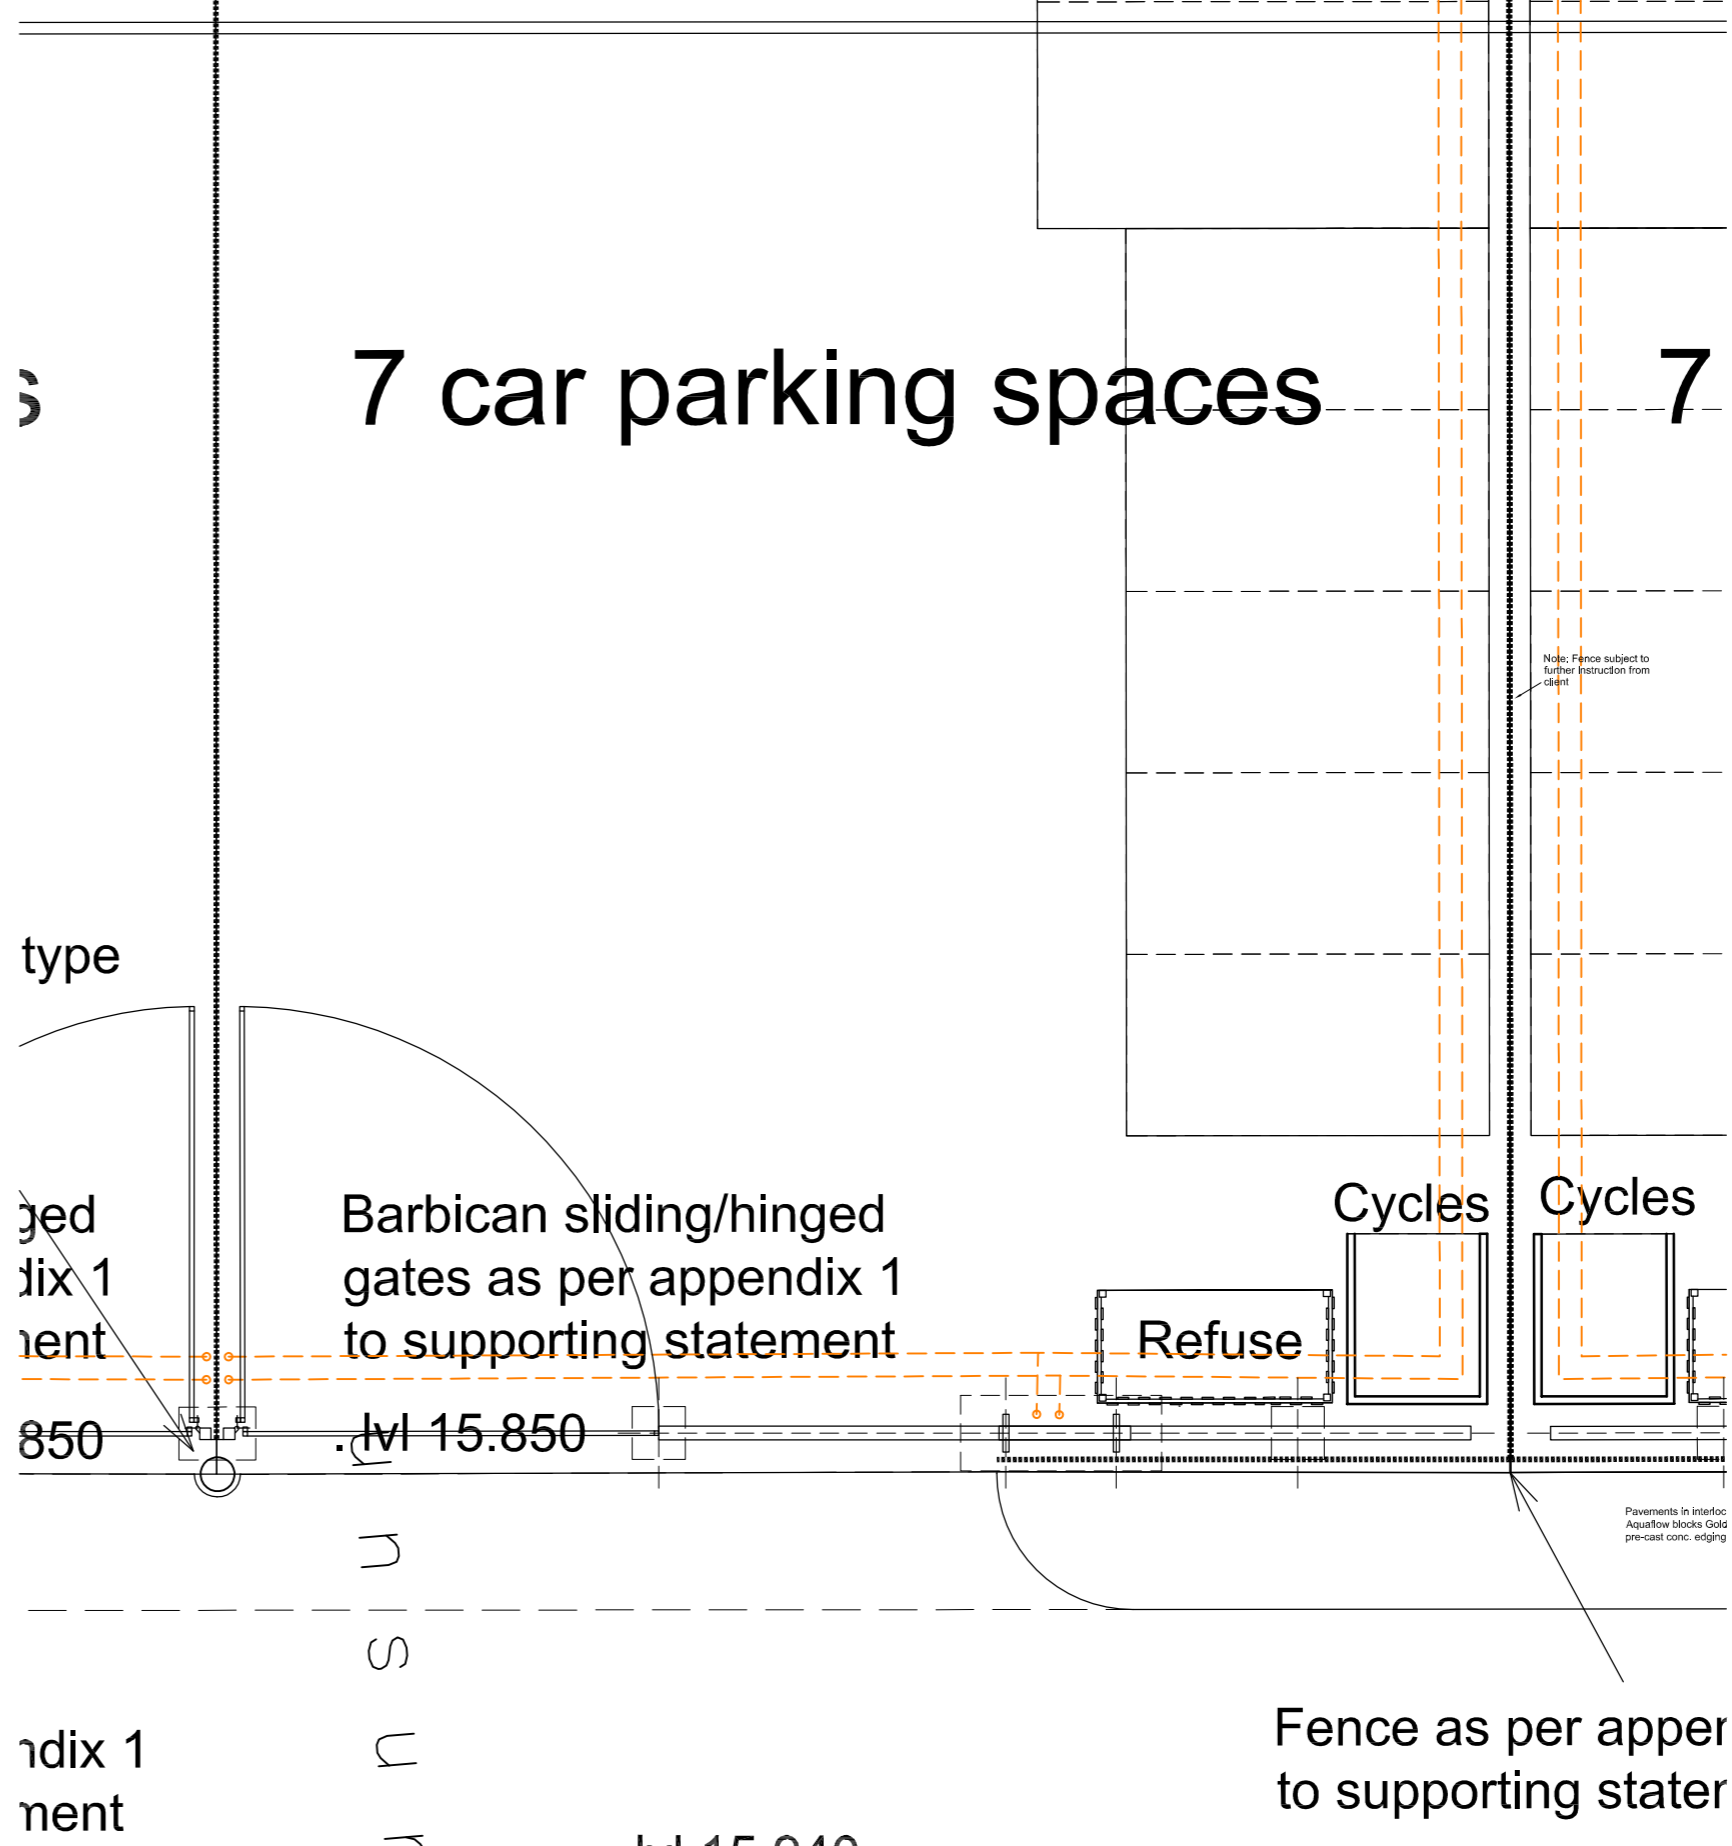

AS BUILT  
COPYRIGHT RESERVED

DATE: NOV 2007  
DRAWING NO: 9798/C/3363  
SCALE: 1:100 at A1  
1:200 at A3  
REV -

UNIT 3

WEST & PARTNERS  
TOWN PLANNING CONSULTANTS  
CHARTERED ARCHITECTS  
ISAMBARO HOUSE, 60 WESTON STREET, LONDON SE1 3QJ  
Fax: 020 7403 6279 Telephone: 020 7403 1726  
E-mail: [pl@westandpartners.com](mailto:pl@westandpartners.com)

PHASE 3  
JEFFREY'S RD. ENFIELD.

GLE PROPERTY DEVELOPMENTS LTD  
AMENDMENTS: